19. LEAD SERVICE LINE REPLACEMENT



ONLY FOR COMMUNITY WATER SYSTEMS

Your water system classification is: Community Water System

Section 116885 of the California Health and Safety Code, Lead Service Lines in Public Water Systems, added to the Health and Safety Code by Senate Bill 1398 (2016) and amended by Senate Bill 427 (2017), requires all community water systems (CWS) to compile an inventory of known partial or total lead user service lines in use in its distribution system by July 1, 2018. The inventory must include all user service lines that are active and those that are reasonably expected to become active in the future. Also, Section 116885 requires that CWS identify areas that may have lead user service lines in use, and/or identify any areas within the CWS distribution system that the CWS cannot identify the material that is being used for the service line.

For additional information, please visit
https://www.waterboards.ca.gov/drinking_water/certlic/drinkingwater/lead_service_line_inventory_pws.shtml

If you have questions about completing this section of the report, please contact David.Pimentel@Waterboards.ca.gov or call (916) 323-0572.

Date lead service line inventory was completed (MM/DD/YYYY): 01/01/1992

A. User service line inventory:

"User service line" means the pipe, tubing, and fittings connecting a water main to an individual water meter or service connection.

Pipe Material	**Estimated Number** of Service Lines (Enter "0" if none)	**Estimated Total Length** of Service Lines **(In feet),** if applicable
A. Lead	85	1,530
B. Unknown material	300	5,400
C. Copper	2,392	66,976
D. Cast iron (ductile pipe)	325	5,850
E. Ductile iron	90	2,520
F. Galvanized steel	500	14,000
G. Polyvinyl chloride (PVC)	80	2,240
H. Polyethylene (PE)	1,200	33,600
I. High density polyethylene (HDPE)	0	0
J. Polybutylene (PB)	350	9,800
K. Transite/asbestos cement	0	0
L. Other materials not listed above:		
Identify material 1		

Identify material 2	
Identify material 3	
Identify material 4	
Total number of service lines inventoried* (calculated field)	5,322
Total number of service connections from Section 3 of the EAR	5,322
Fittings or fittings connecting a water main:	
M. Lead fittings NOT on a lead pipe(e.g., goosenecks, pigtails, and corporation stops)	600
N. Lead fittings ON a lead pipe (e.g., goosenecks, pigtails, and corporation stops)	0
O. Fittings of unknown material (e.g., goosenecks, pigtails, and corporation stops)	300
Total number of lead service lines** (calculated field)	685

*Total number of service lines inventoried (calculated field) = Sum of A through L

**Total number of lead service lines (calculated field) = Sum of A and M

To Update calculated field, click button below

To update totals click here

B. Method(s) used to prepare the lead service line inventory in Part A (check all that apply):

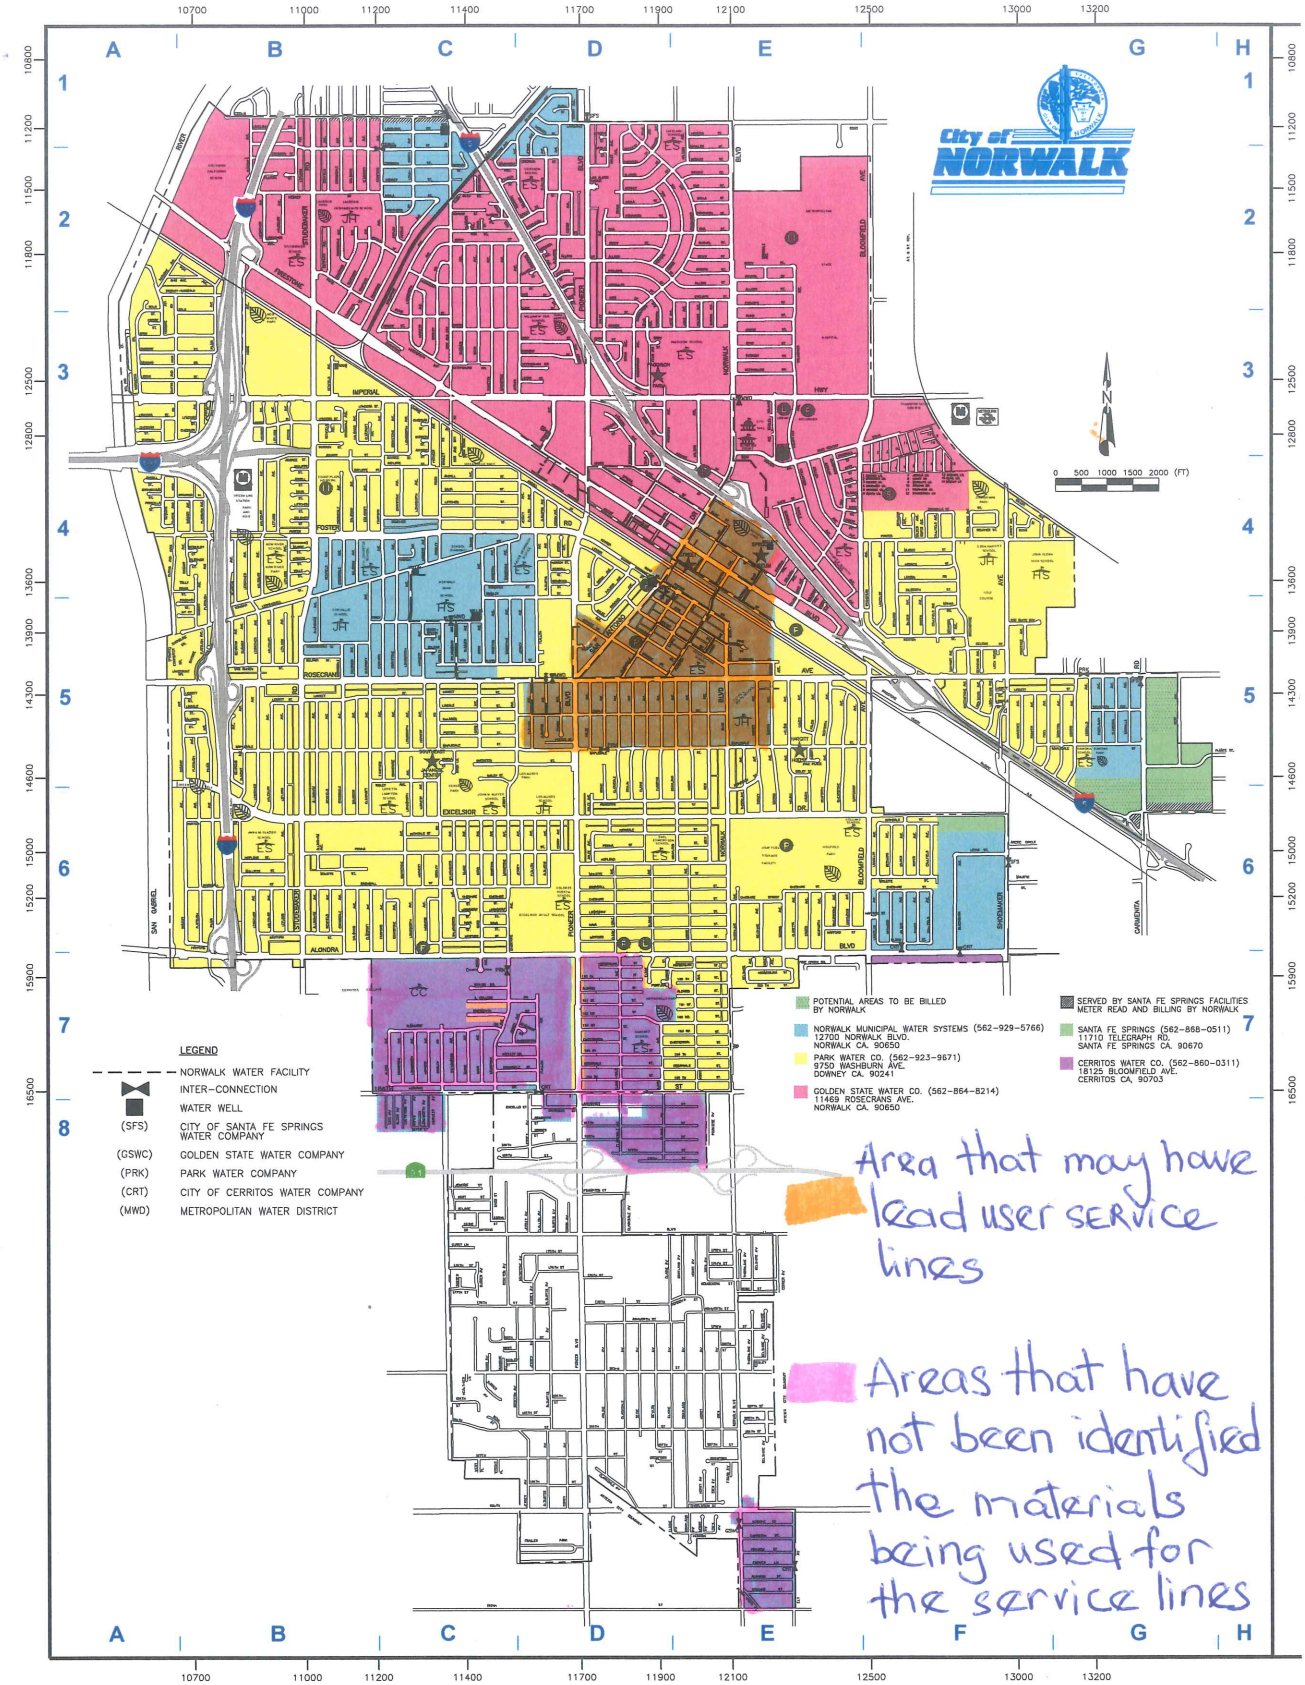
- ☐ Tap Cards or tickets from initial service installation
- ☐ Plans from water main installation, rehabilitation, and replacement
- ☑ Records indicating when buildings were constructed
- ☐ Meter replacement records
- ☐ Distribution maps, drawings, or GIS
- ☑ Visual confirmation of pipe material by plumbers or utility crews during maintenance or installation activities
- ☑ Interviews with water system personnel and/or past employees
- ☑ Field investigations
- ☐ Other (describe below):

C. PRINT THIS INVENTORY FORM FOR YOUR SIGNATURE

I certify under penalty of perjury under the laws of the State of California that the foregoing [including any uploaded documents] is true and correct to the best of my knowledge.

Signature:	
Name:	Julian Lee
Title:	Utilities and Projects Manager
Phone number:	(562) 929-5926
Date signed (MM/DD/YYYY):	05/31/2018 11/1/2018
PWS Name:	NORWALK - CITY, WATER DEPT.
PWS No.:	CA1910191

Print this completed form by clicking "Print" below, sign and scan. This is your certified form.
Print


City of NORWALK
LEGEND
NORWALK WATER FACILITY
INTER-CONNECTION
WATER WELL
(SFS) CITY OF SANTA FE SPRINGS WATER COMPANY
(GSWC) GOLDEN STATE WATER COMPANY
(PRK) PARK WATER COMPANY
(CRT) CITY OF CERRITOS WATER COMPANY
(MWD) METROPOLITAN WATER DISTRICT
POTENTIAL AREAS TO BE BILLED BY NORWALK
NORWALK MUNICIPAL WATER SYSTEMS (562-929-5766) 12700 NORWALK BLVD. NORWALK CA. 90650
PARK WATER CO. (562-923-9671) 9750 WASHBURN AVE. DOWNEY CA. 90241
GOLDEN STATE WATER CO. (562-864-8214) 11469 ROSECRANS AVE. NORWALK CA. 90650
SERVED BY SANTA FE SPRINGS FACILITIES METER READ AND BILLING BY NORWALK
SANTA FE SPRINGS (562-868-0511) 11710 TELEGRAPH RD. SANTA FE SPRINGS CA. 90670
CERRITOS WATER CO. (562-860-0311) 18125 BLOOMFIELD AVE. CERRITOS CA. 90703
0 500 1000 1500 2000 (FT)
Area that may have lead user service lines
Areas that have not been identified the materials being used for the service lines